



The Public Works Wastewater Collection Division will be starting its annual sewer line flushing and videoing at the end of March, 2017. Each year our wastewater crews clean ¼ of the sewer lines in the City. This year the lines scheduled for cleaning are South of 200 North and East of I-15 and also include the Eagle Ridge Subdivision. The City does not clean sewer lines in Planned Unit Developments (PUDs.) Sewer line cleaning will continue through September, 2017 in this section of the City. If you have any questions, please contact the Public Works Department at 435-586-2912.

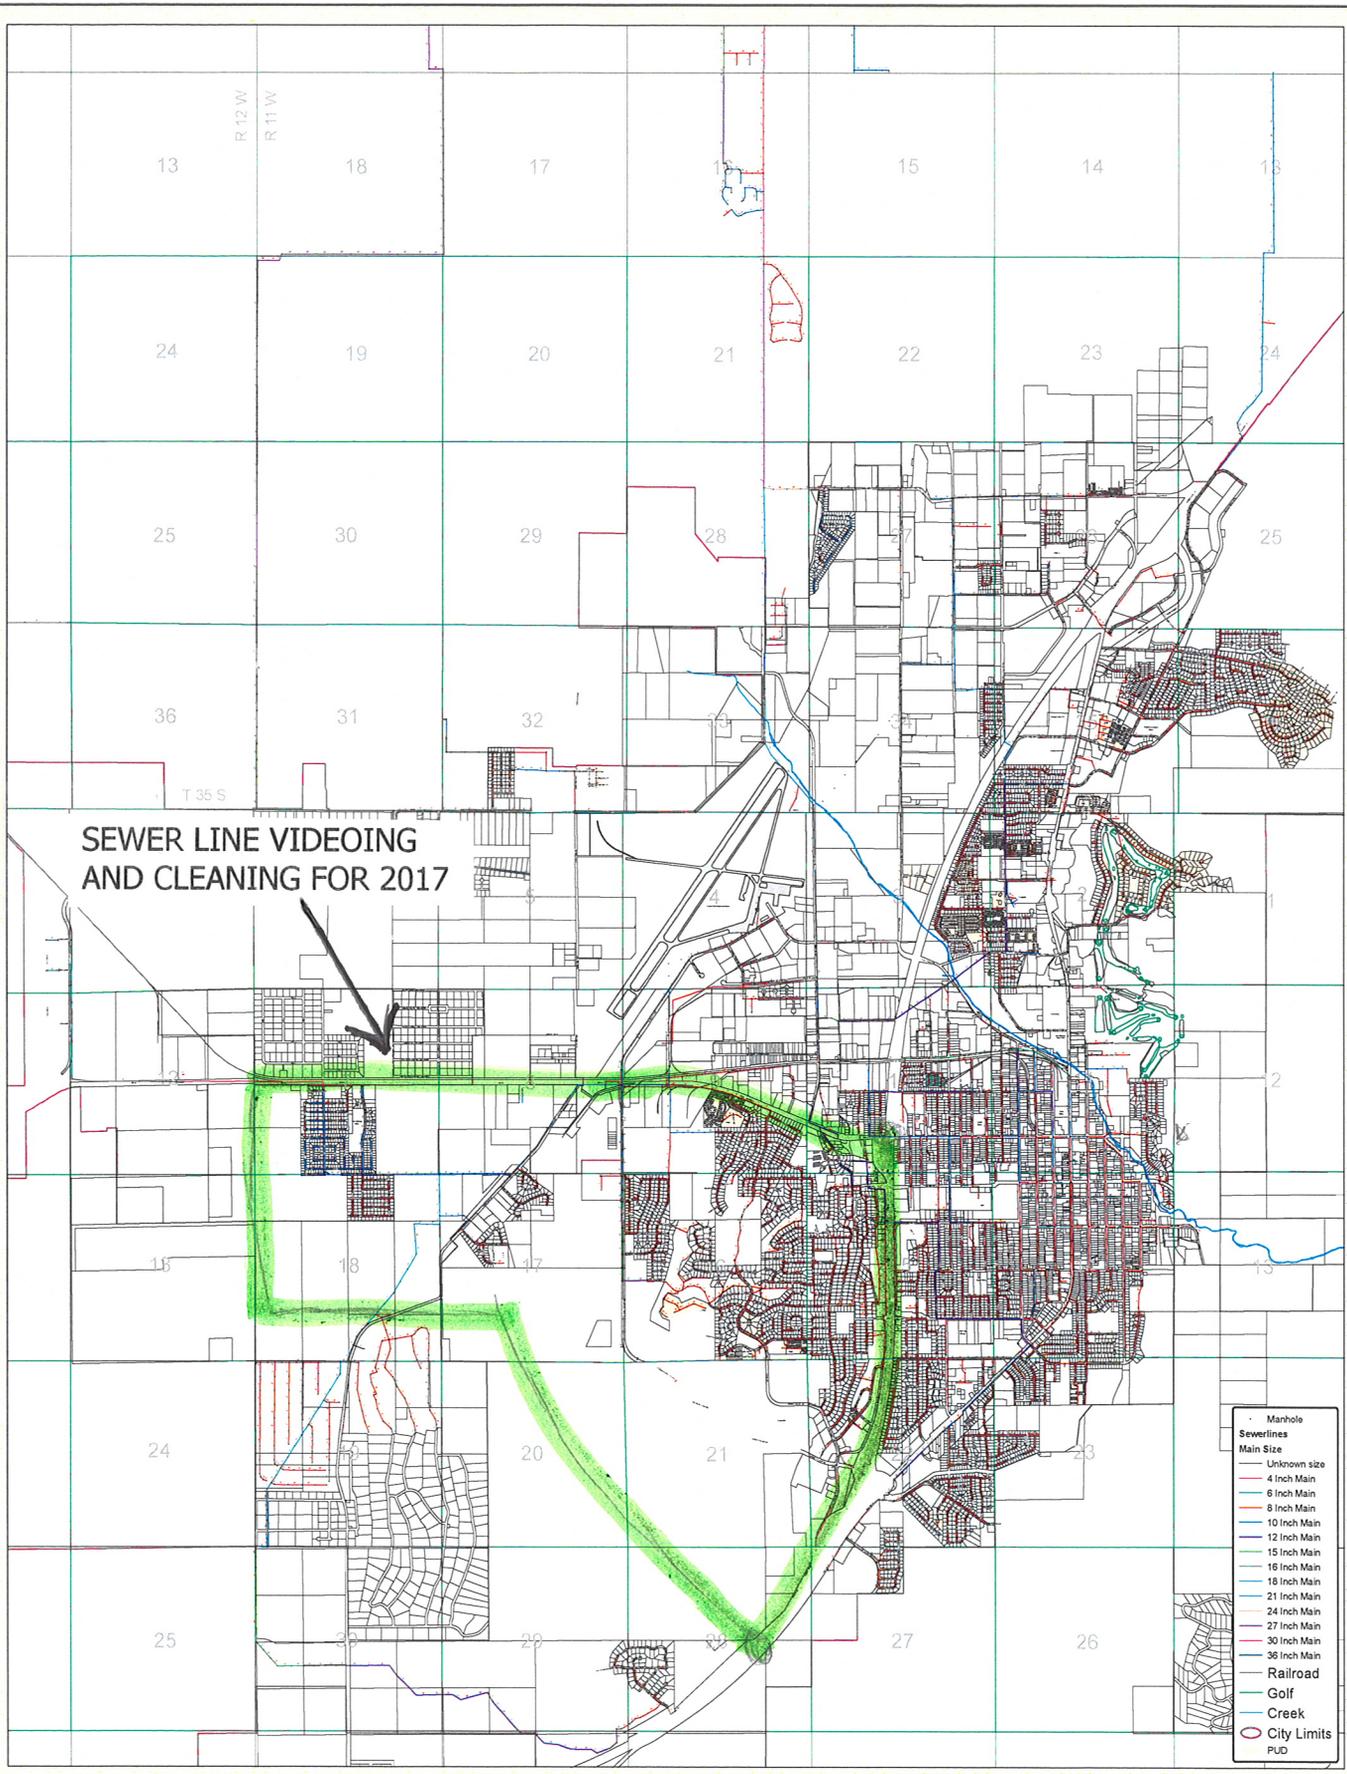

**SEWER LINE VIDEOING
AND CLEANING FOR 2017**

Manhole	
•	Sewerlines
Main Size	
—	Unknown size
—	4 Inch Main
—	6 Inch Main
—	8 Inch Main
—	10 Inch Main
—	12 Inch Main
—	15 Inch Main
—	16 Inch Main
—	18 Inch Main
—	21 Inch Main
—	24 Inch Main
—	27 Inch Main
—	30 Inch Main
—	36 Inch Main
—	Railroad
—	Golf
—	Creek
○	City Limits
○	PUD

CEDAR CITY CORPORATION
SEWER MAIN ASBUILT MAP

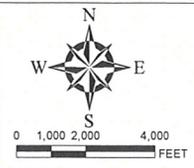

Printed January 14, 2015