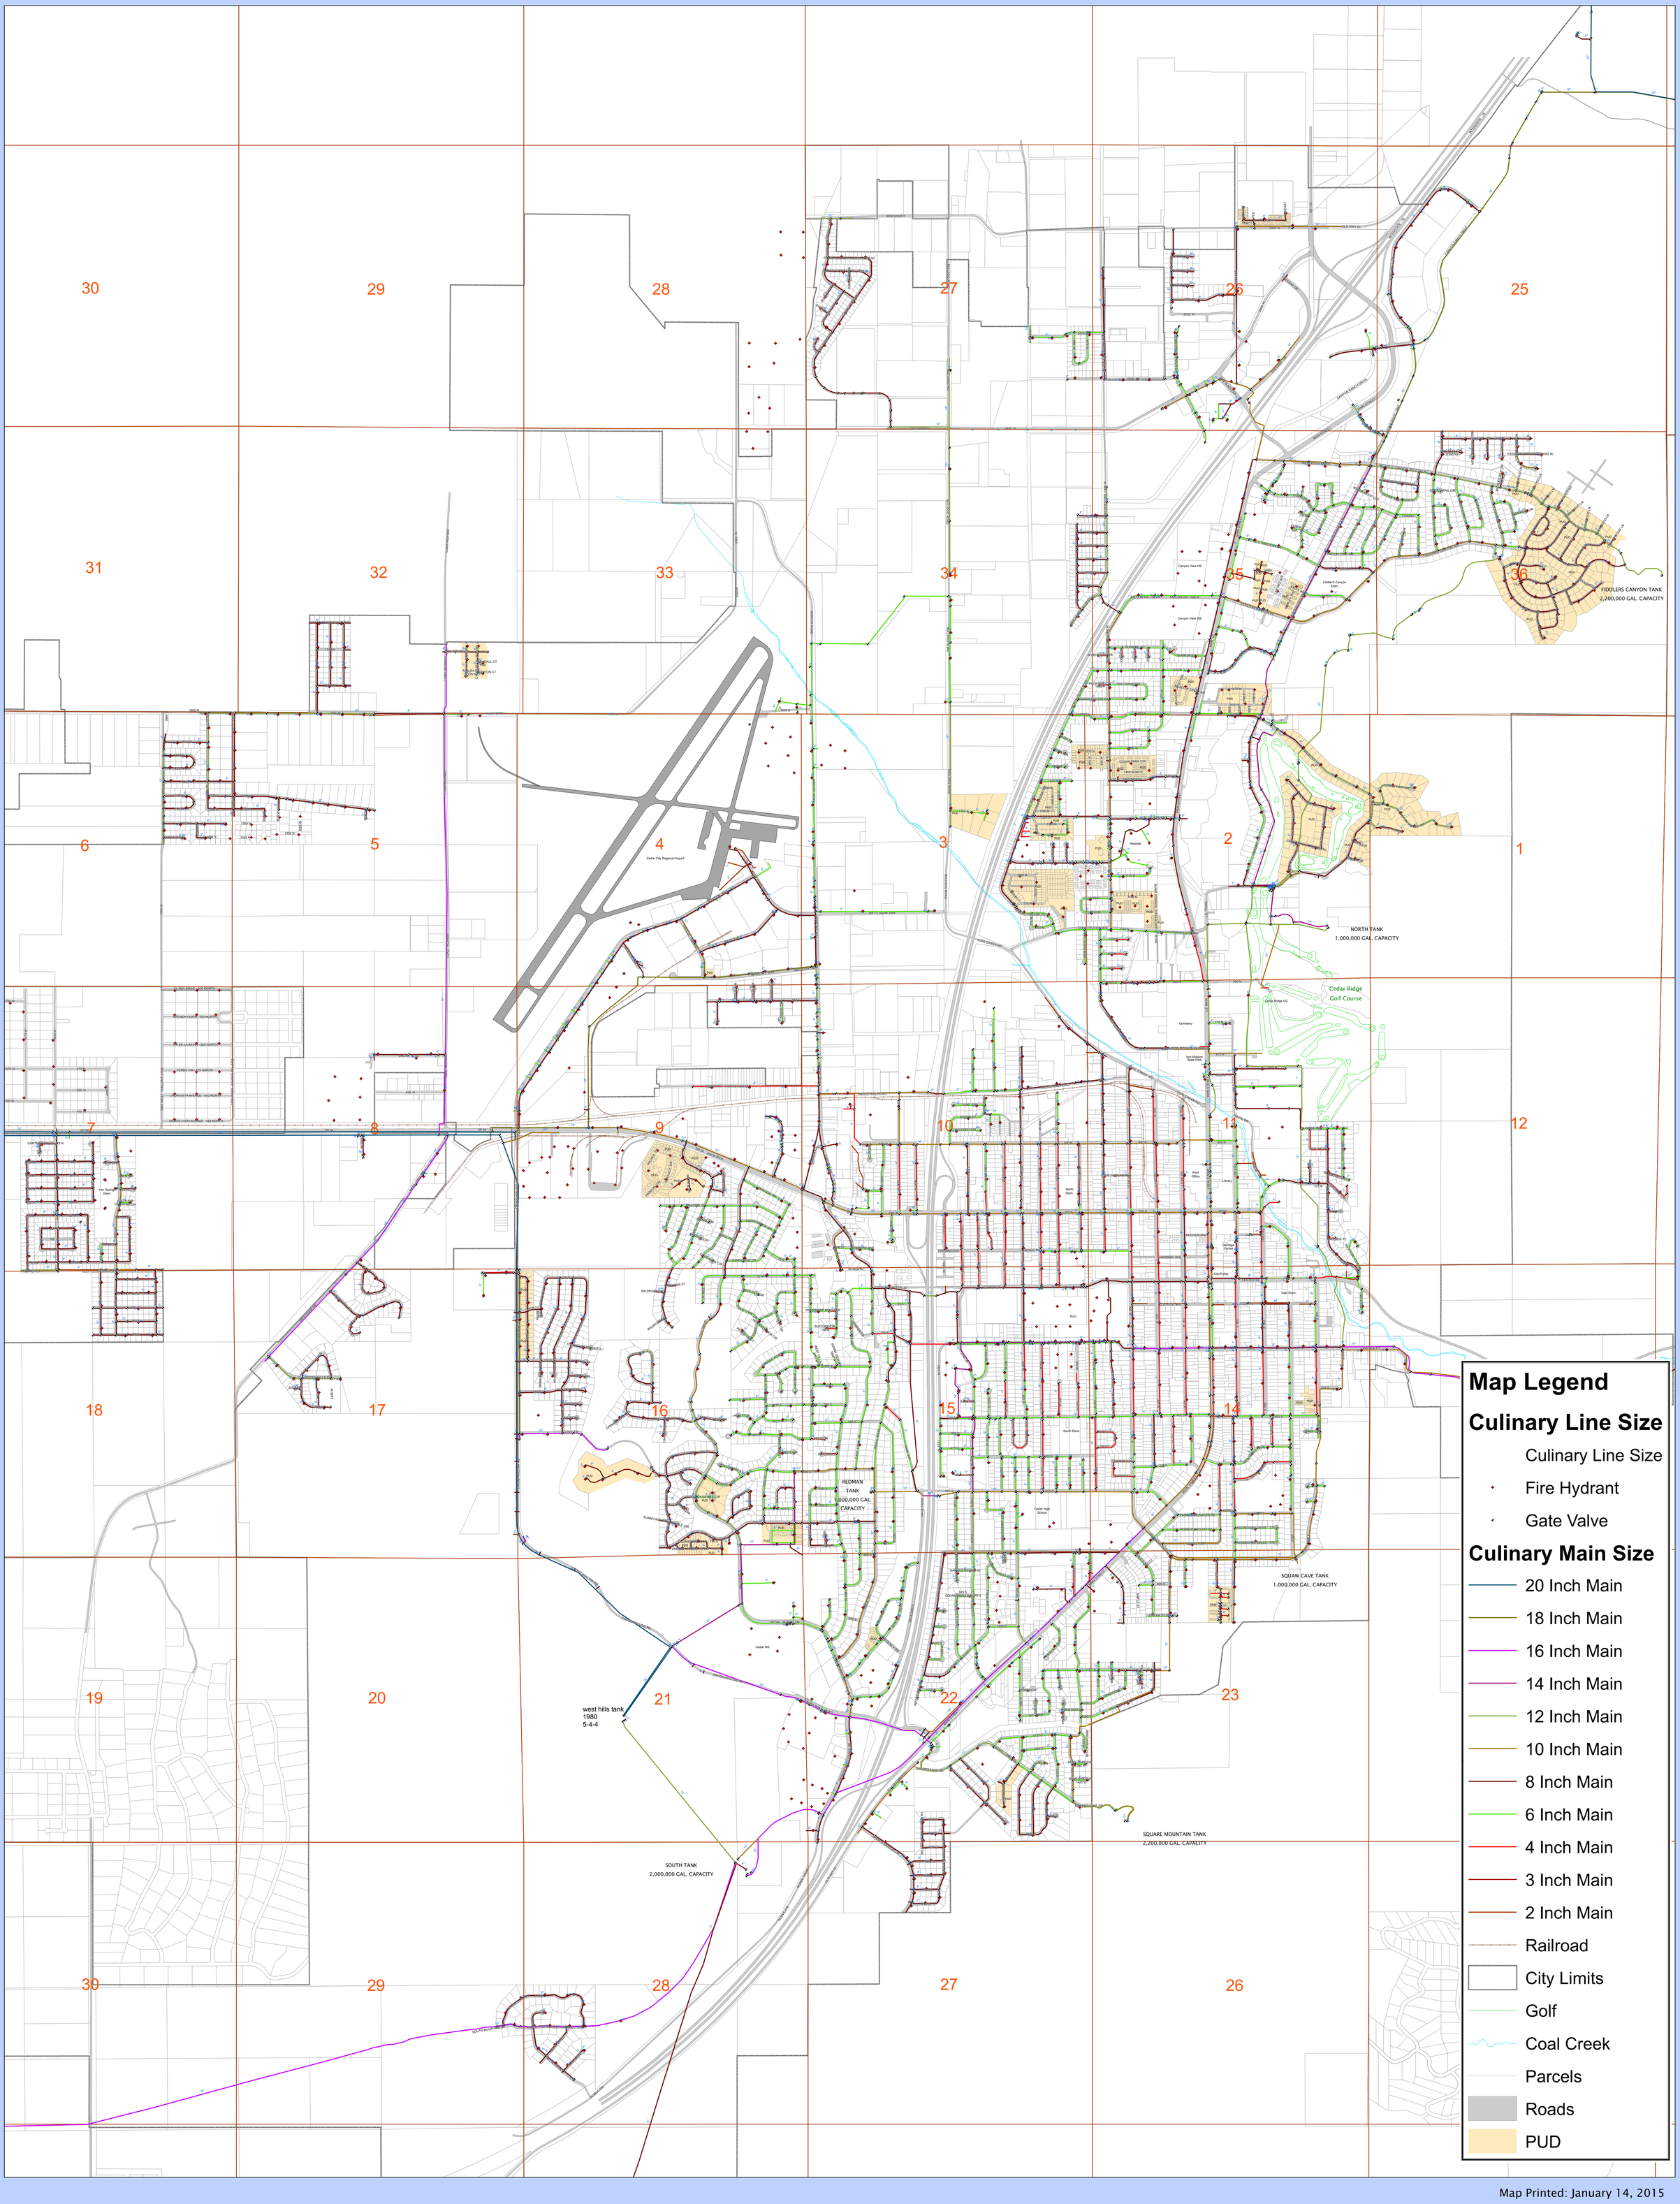

Map Printed: January 14, 2015

CEDAR CITY CORPORATION

CULINARY WATER MAIN ASBUILT MAP

N
W E
S

Scale: 1"=800'

CEDAR CITY CORP.
10 North Main
Cedar City, Utah 84720